



TRAFFIC BOARD APPLICATION

Binghamton Traffic Board
City Hall, Government Plaza
38 Hawley Street, 4th Floor
Binghamton, NY 13901
<http://www.binghamton-ny.gov>

For Internal Use Only	
Approved: <input type="checkbox"/>	Denied: <input type="checkbox"/>
Referred to: _____	

DIRECTIONS: Please print or type. Please answer all questions completely.

NAME: Juliet Berling/Planning

ADDRESS: 92 Park Ave
(Number) (Street) (City)

EMAIL ADDRESS: jumberling@cityofbinghamton.gov

TELEPHONE: 772-7028 **DATE:** 05 / 01 / 2023

LOCATION OF TRAFFIC BOARD REQUEST (street address or intersection):
92 Park Ave and Cross Street

DESCRIBE THE REQUEST (be as specific as possible, use additional pages if necessary):
We would like the follpowing to be considered:

1.) 12 foot curb cut and driveway apron installed to create an onsite parking space for 1-2 vehicles;

2.) Existing Stop sign at the border of 92 Park property line replaced with a Yield sign;

3.) A crosswalk painted in front of remaining Stop sign on Cross St;

4.) Have the 15 min parking sign removed in front of 92 Park Ave.




#1 Car cut a drive over

Google


#A Reglar And Stop Sign w/ Yield



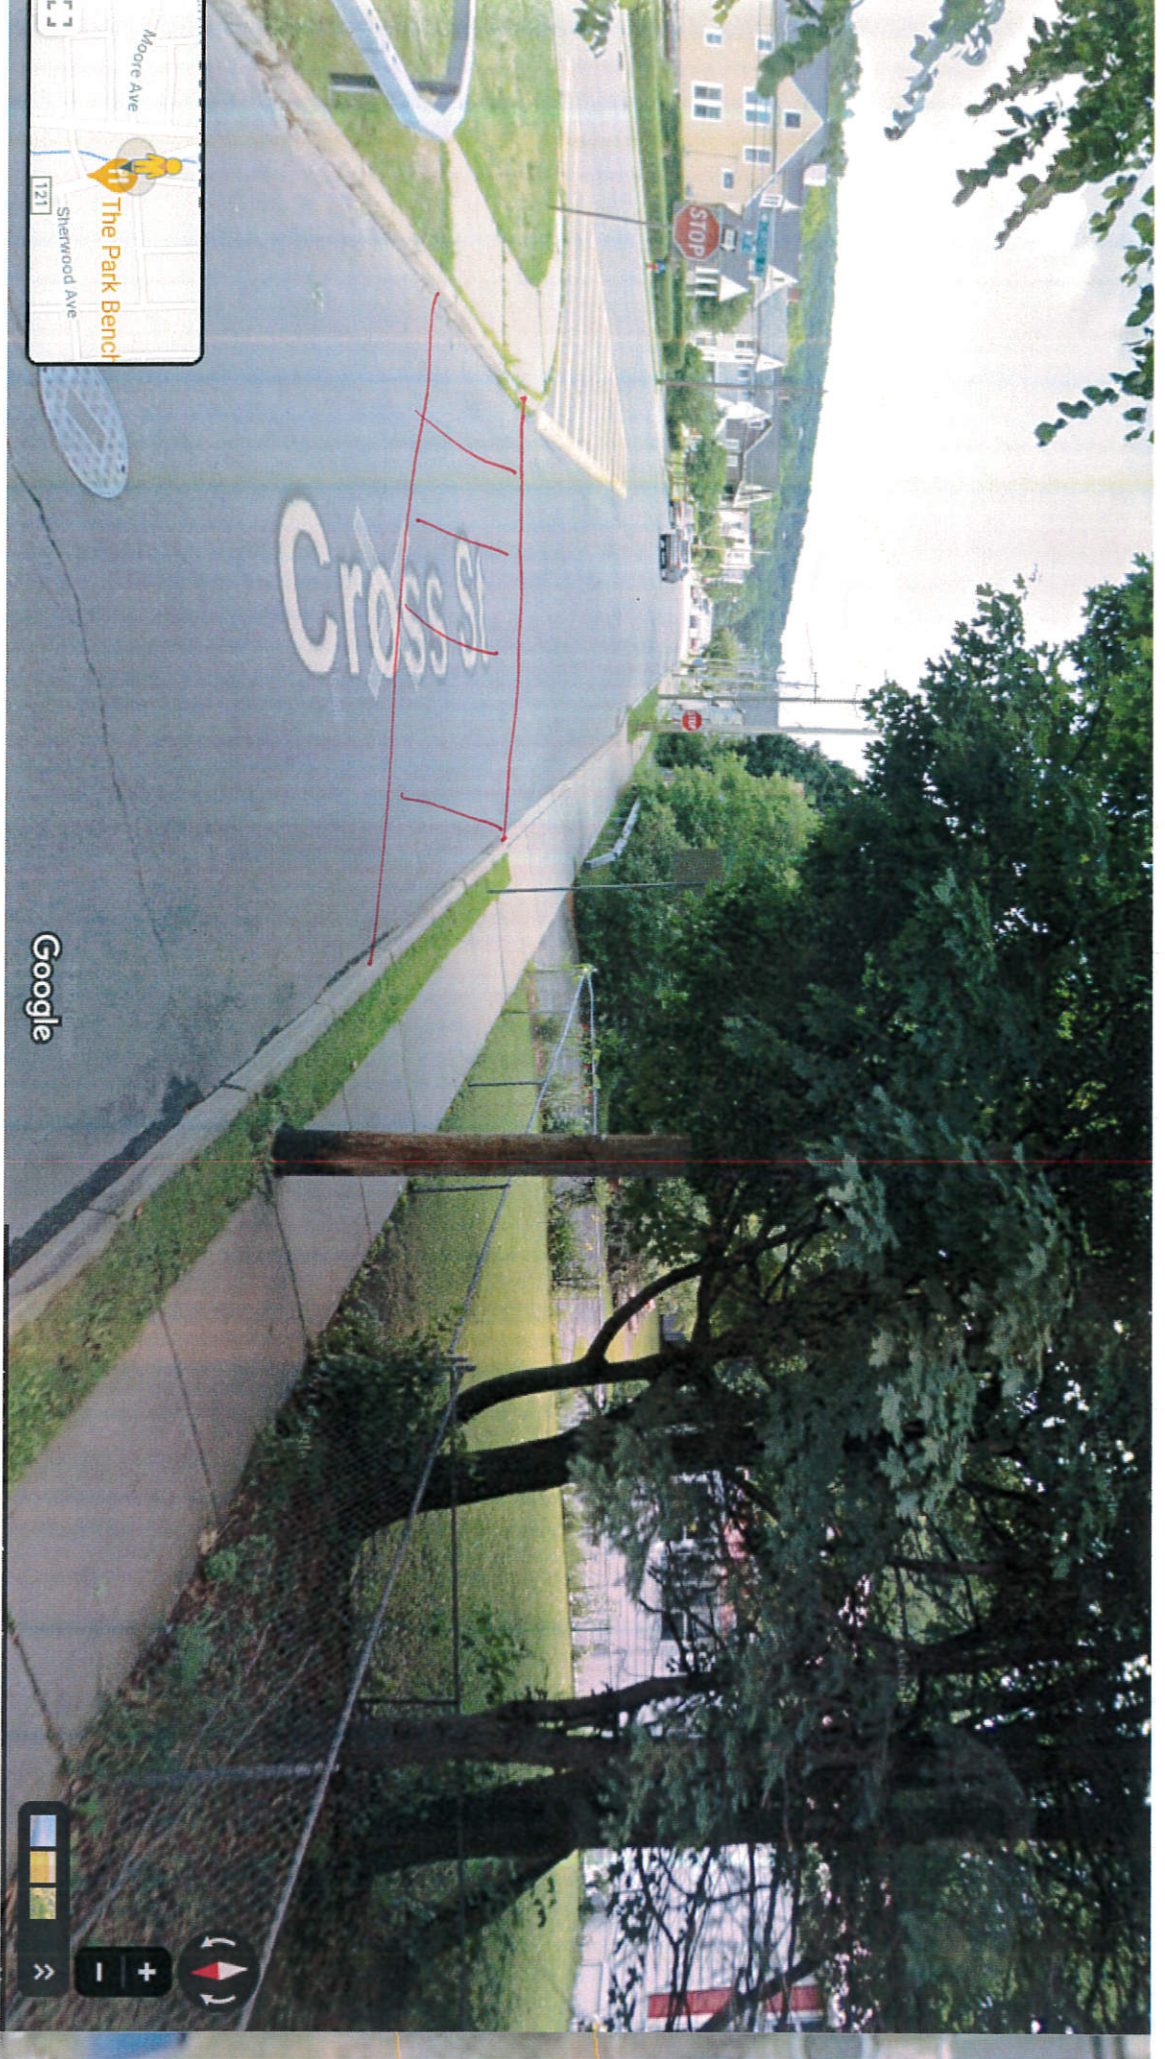

#3 Paint crosswalk

#4 Lense 15 min Parking Sign

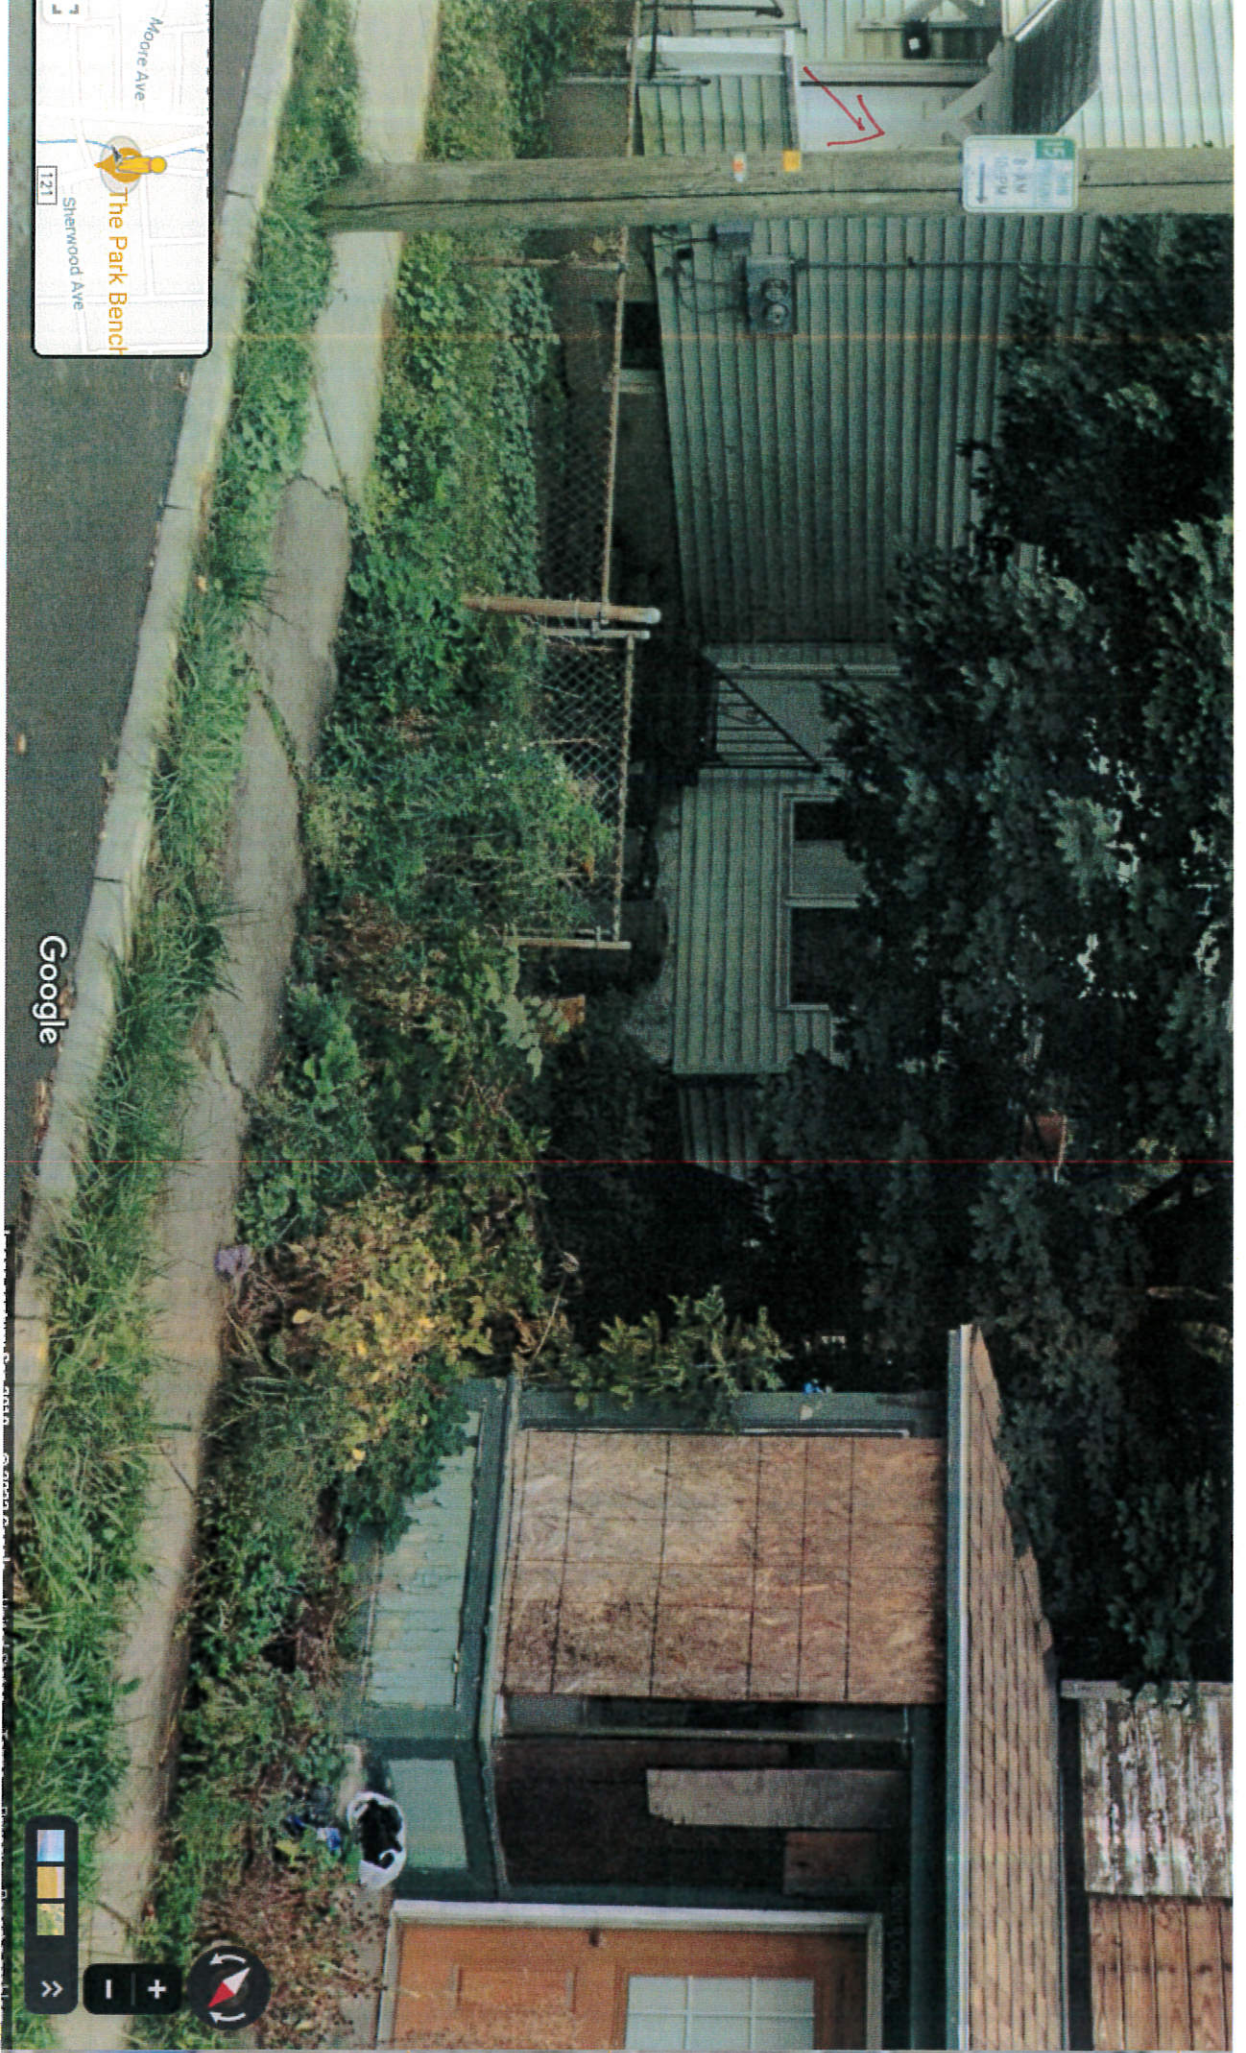



TRAFFIC BOARD APPLICATION

Binghamton Traffic Board
City Hall, Government Plaza
38 Hawley Street, 4th Floor
Binghamton, NY 13901
<http://www.binghamton-ny.gov>

For Internal Use Only	
Approved: <input type="checkbox"/>	Denied: <input type="checkbox"/>
Referred to: _____	

DIRECTIONS: Please print or type. Please answer all questions completely.

NAME: Wendy Ogden Szuba

ADDRESS: 25 Jerome Ave
(Number) (Street) (City)

EMAIL ADDRESS: wogdenszuba@yahoo.com

TELEPHONE: (612) 408-2671 DATE: 05 / 01 / 2023

LOCATION OF TRAFFIC BOARD REQUEST (street address or intersection):
25 Jerome Ave

DESCRIBE THE REQUEST (be as specific as possible, use additional pages if necessary):
I am widening my driveway from 9 feet to 18 feet and would like to
widen the driveway apron to 22 feet to accomodate the new driveway
width, similar to my neighbors driveway. The City is repaving Jerome
and replacing sidewalks this summer, I would like the new curb cut
to be made at the same time as the rest of the street work, if approved.



1851

189


Orton St
Schiller St

Google

Google




Jerome Ave

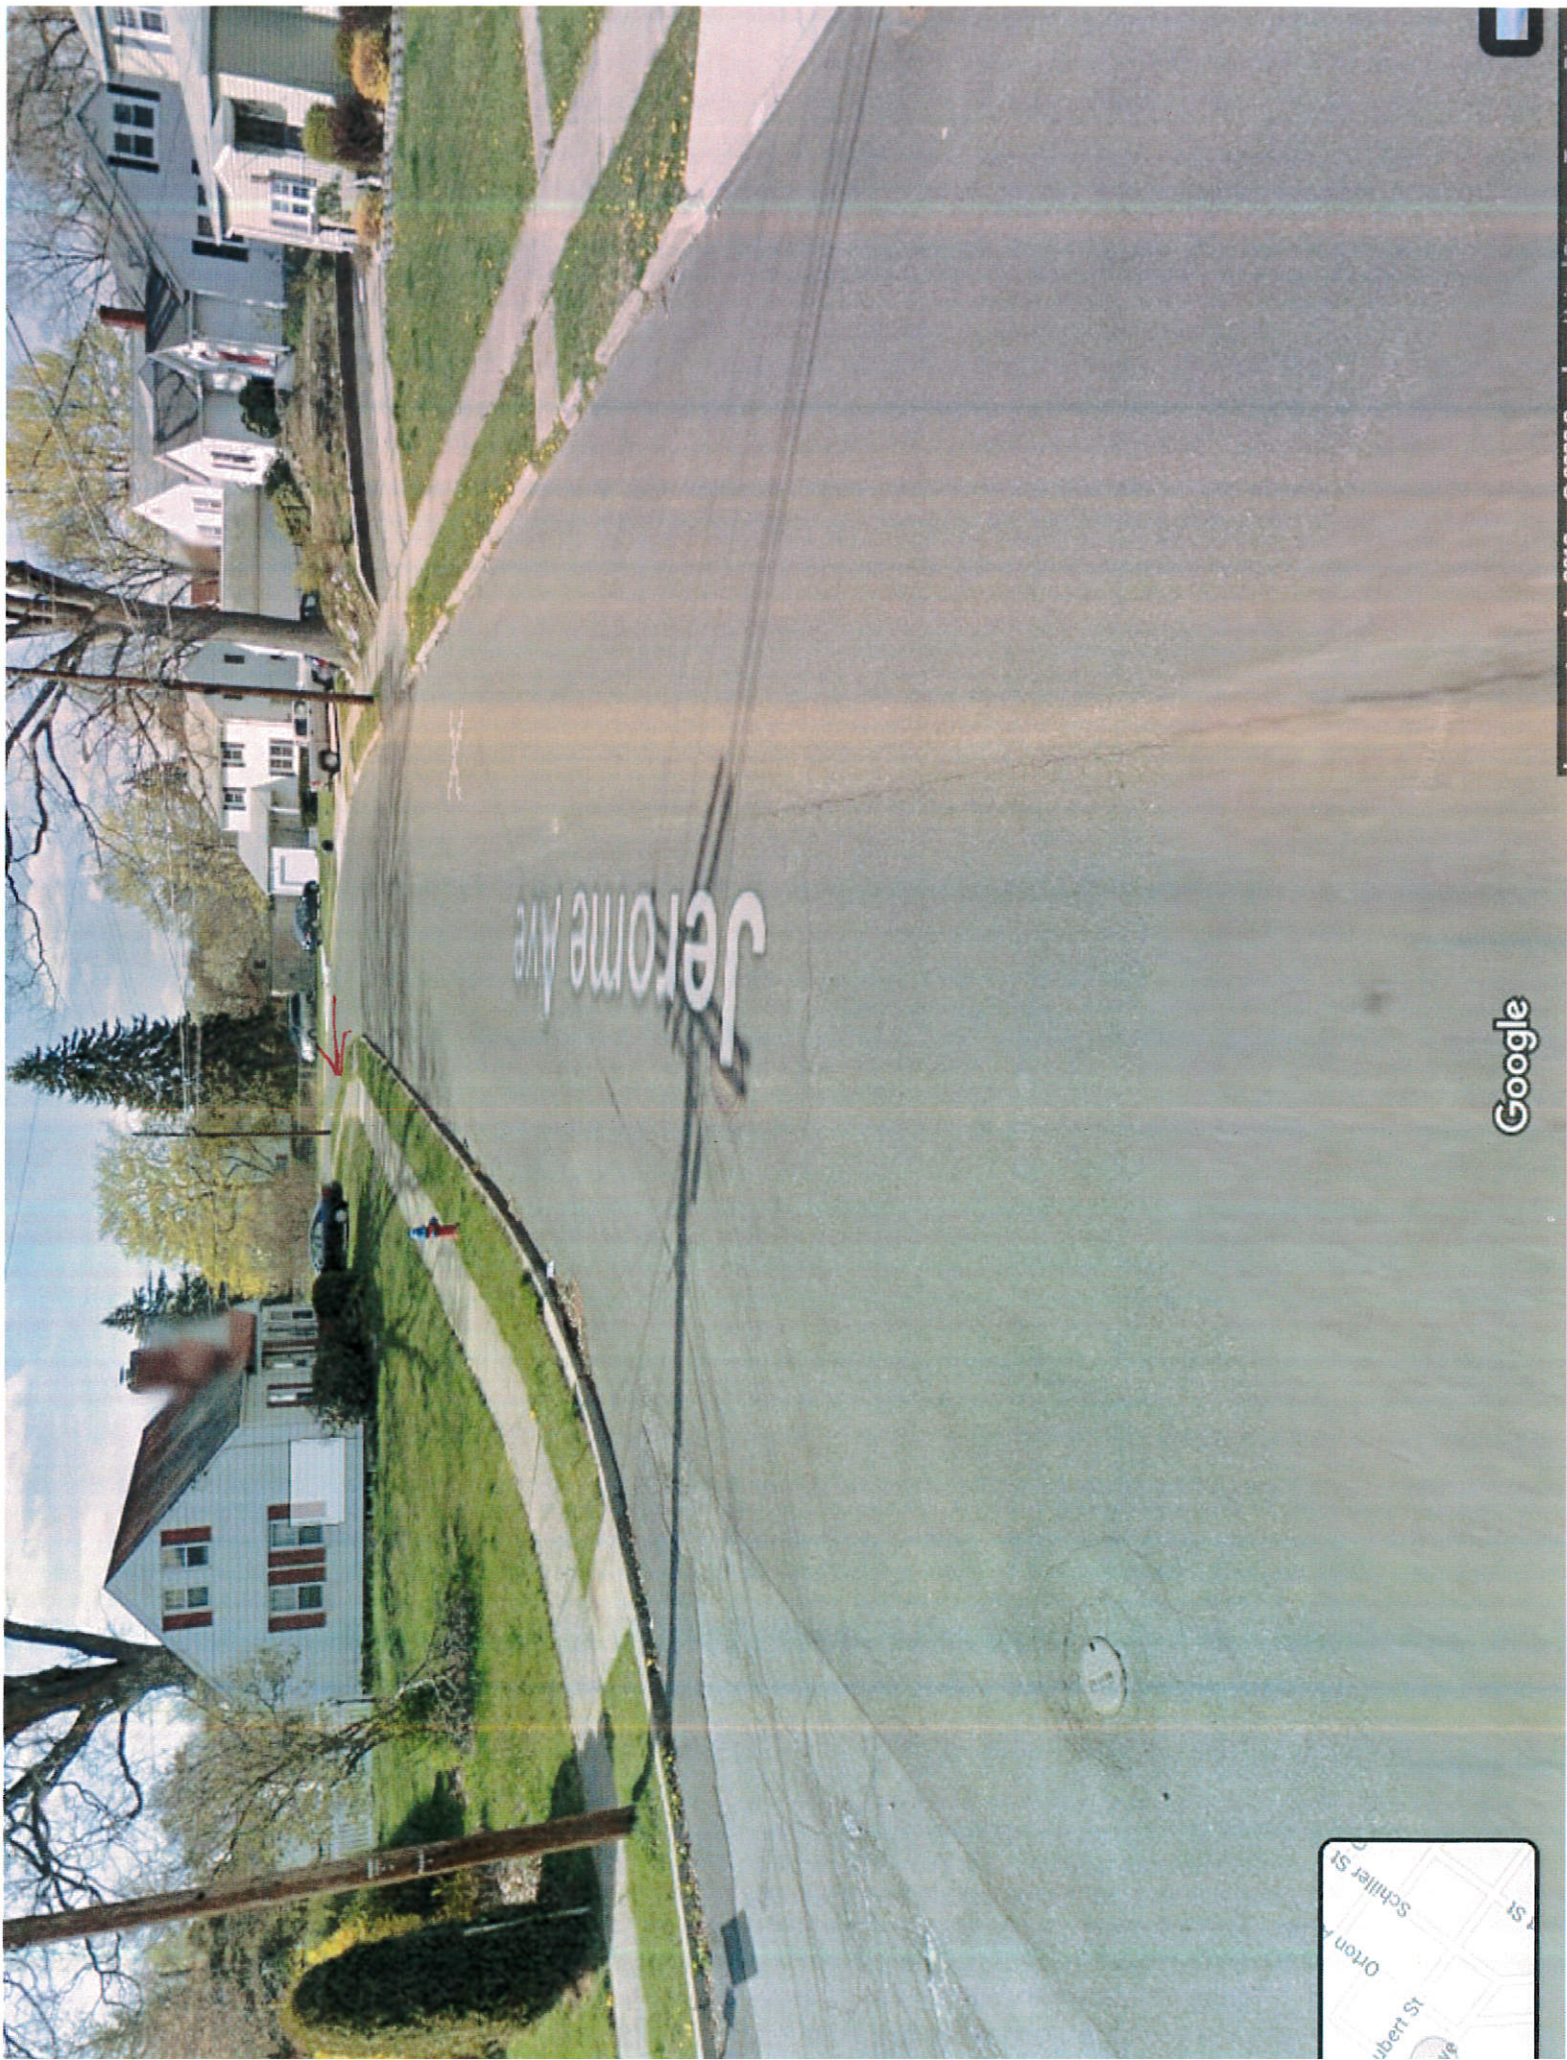



20 ft

Google

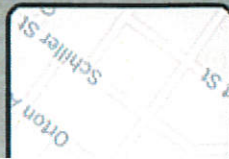



It is a violation of New York Education Law Article 145 Sec. 7209, for any person, unless acting under the direction of a licensed architect, professional engineer, or land surveyor, to alter an item in any way. If an item bearing the seal of an architect, engineer, or land surveyor is altered, the altering architect, engineer, or land surveyor shall affix to the item their seal and notation "altered by" followed by their signature and date of such alteration, and a specific description of the alteration.

© 2020 LaBella Associates

**Family & Children's
Counseling Services**



**FAMILY & CHILDREN'S
COUNSELING SERVICES**

257/261 MAIN STREET
BINGHAMTON, NY 13095

NO.	DATE	DESCRIPTION
1	7/1/2020	(1) MH CHANGED TO CB; EDITS FOR CLARITY

PROJECT NUMBER: 2192197

DRAWN BY: EWB

REVIEWED BY: DRW

ISSUED FOR: PERMIT


DATE: 05/29/2020

DRAWING NAME:

PROPOSED SITE PLAN



DRAWING NUMBER:

C201

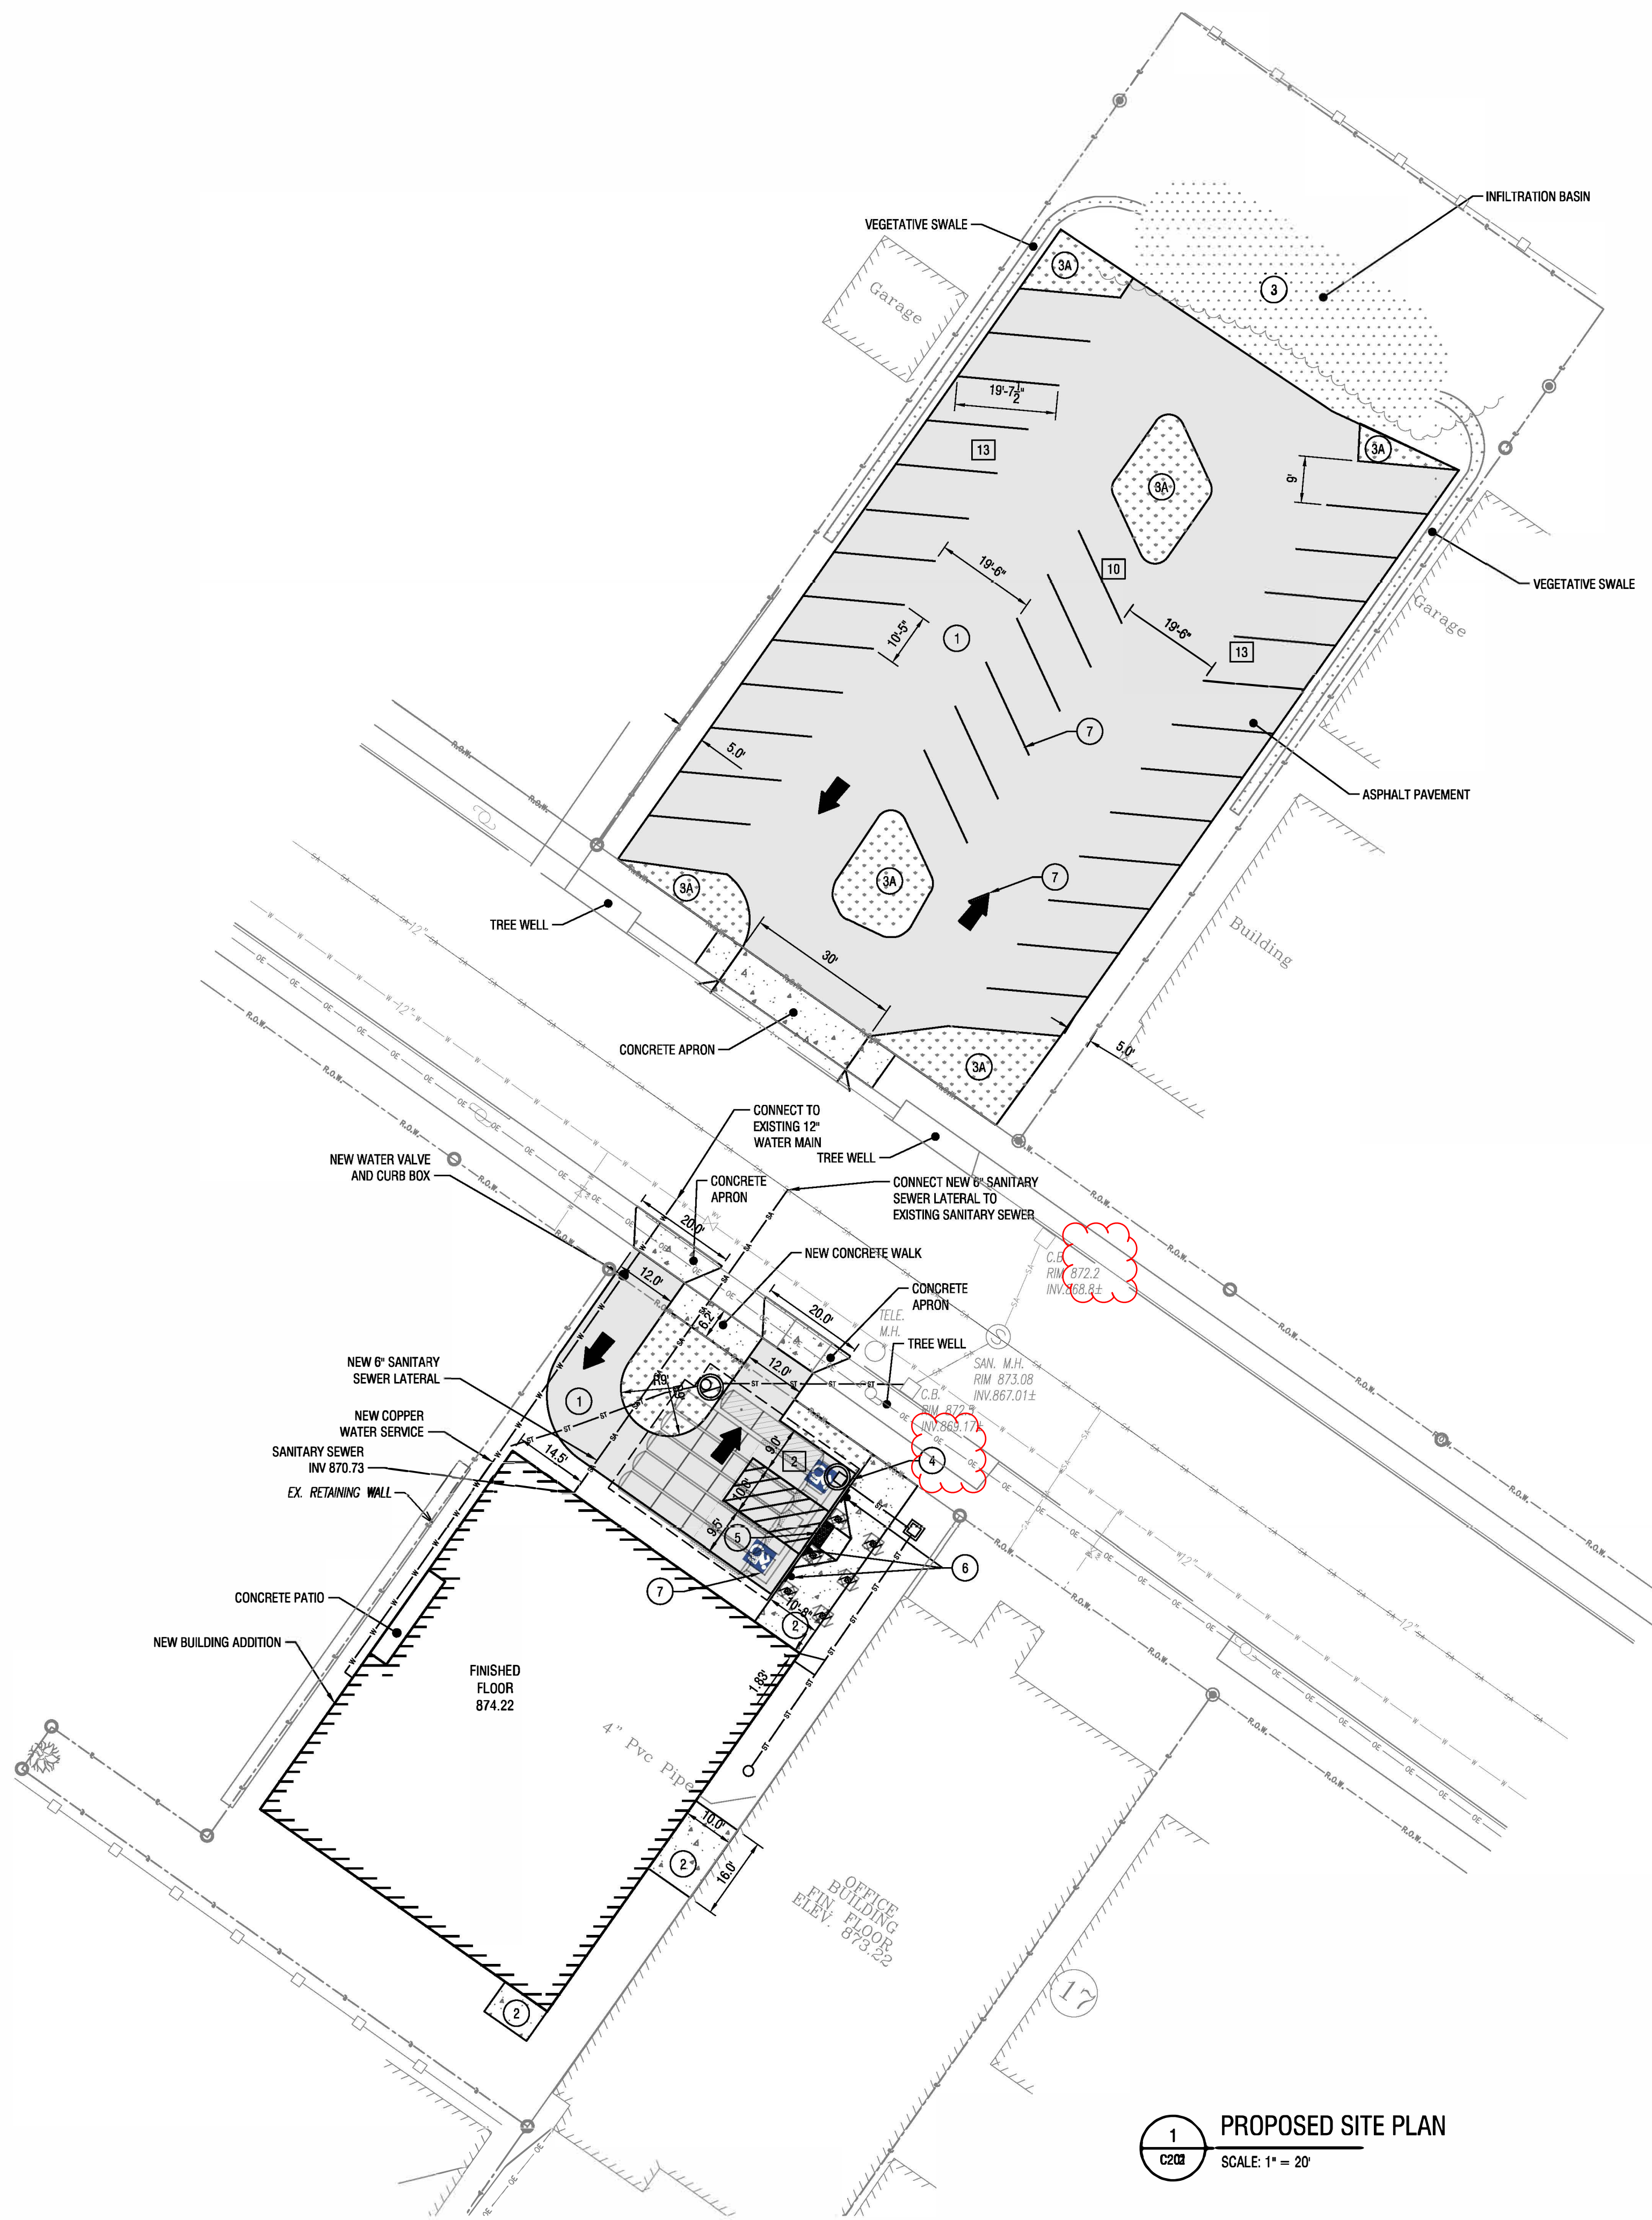

1.7 CIVIL / SITE WORK: IS YOUR CONTRACTOR RESPONSIBLE FOR UTILITY INSTALLATION IN THE RIGHT OF WAY AND THE TAP ONTO THE MAIN? PLEASE PROVIDE CONTACT FOR THE CITY OF BINGHAMTON WATER AND SEWER.
A. CONTRACTOR CAN CONTACT THE WATER / SEWER SUPERINTENDENT AT THE CITY OF BINGHAMTON, JEFFERY KRUGER 607-772-7210.

- LEGEND**
- 1 NEW FULL DEPTH STANDARD DUTY ASPHALT PAVEMENT
 - 2 NEW CONCRETE WALK
 - 3 STORM WATER FACILITIES
 - 3A TOPSOIL AND SEED
 - 4 NEW CONCRETE CURB
 - 5 HANDICAP RAMP W/ DETECTABLE WARNING
 - 6 SIGNAGE
 - 7 PAVEMENT MARKINGS

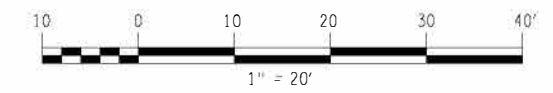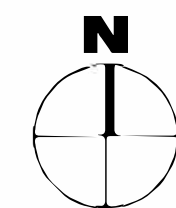

1 PROPOSED SITE PLAN
SCALE: 1" = 20'